Dart Aerospace Ltd. Tuesday, 8/1/2006 11:31:26 AM User: Kim Johnston **Process Sheet Drawing Name** : INNER FWD SADDLE : CU-DAR001 Dart Helicopters Services Customer **Job Number** : 28080 **Estimate Number** : 11079 Part Number : D5953 : NIA P.O. Number S.O. No. 7 N/A : D5953 REV A **Drawing Number** : 8/1/2006 This Issue : N/A Project Number Prsht Rev. : MACHINED PARTS Type **Drawing Revision** First Issue Material **Previous Run** : 8/31/2006 4 Um: **Due Date** Qty: Written By Checked & Approved By 05-11-29 JLM Comment : Est Rev:E Re-Format **Additional Product** Job Number: Description: Machine Or Operation: Seq. #: 7075-T7351 8.25X7.75X2.5 1.0 D6101007 Comment: Qty.: 4.0000 Each(s) 1.0000 Each(s)/Unit Total: D6101-007(7075-T7351) Size 2.50" x 7.50" X 8.25" (Grain along 7.50") En 06/11/07 2.0 HAAS3 Comment: HAAS CNC VERTICAL MACHINING #3 1-Machine as per folio D5953,Ensure Batch Number is entered 5.1 1328080 2-Machine Keyway PTO E0 06/11/08 3-Deburr & Tumble INSPECT ALL DIM TO DIM SHEET 3.0 Comment: INSPECT ALL DIM TO DIM SHEET SECOND CHECK 4.0 QC8

Comment: SECOND CHECK


HAND FINISHING1

HAND FINISHING RESOURCE #1

Comment: HAND FINISHING RESOURCE #1

Chemical Conversion Coat as per QSI 005 4.1



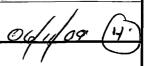

Each

5.0

## Dart Aerospace Ltd

W/O:		WORK ORDER CHANGES								
DATE	STEP	PROCEDURE CHANGE		Ву	Date	Qty	Approval Mfg / Design Mgr	Approval QC Inspector		
05-11-03	2	CHAMFER 0.033 x 45° WAS ADDED AND CALLED	(V). SIMILIAR TO DASFI	PH						
0.0		SEE ATTACHED		80.11.00				06.11.03		
	ļ							06.17.		

NCR:			WORK ORDER NON-CONFORMANCE (NCR)							
	Desc	Description of NC	Description of NC				Vifi4i		Annroyal	
DATE	STEP	Section A	Initial Design Mgr	A	ction Description  Design Mgr	Sign & Date	Verification Section C	Approval Design Mgr	Approval QC Inspector	
	,									
					*					
			·							
		,	:		-					

Part No:	PAR #:	Fault Category:	NCR:	Yes No DQA:	Date: 06/11/1
NOTE: Date & initial all entries				QA: N/C Closed:	Date:

Tuesday, 8/1/2006 11:31:26 AM Date: Uşer: Kim Johnston **Process Sheet** Drawing Name: INNER FWD SADDLE Customer: CU-DAR001 Dart Helicopters Services Part Number: D5953 Job Number: 28080 Job Number: Seq. #: Description: Machine Or Operation: POWDER COATING POWDER COATING 6.0 **Comment: POWDER COATING** Powder Coat White Gloss (Ref: 4.3.5.1) as per QSI 005 4.3 7.0 QC3 Comment: INSPECT POWDER COAT/CHEMICAL CONVERSION PACKAGING RESOURCE #1 8.0 Comment: PACKAGING RESOURCE #1 Identify and Stock Location: DC 9.0 Comment: DOCUMENT CONTROL Inspection Level 21 Job Completion CZ06/11/13

## **Dart Aerospace Ltd**

H:\forms\Quality Assurance\approved forms\NCRWO revC

W/O:			WOR	K ORDER CHANGES	1			
DATE	STEP	PRO	OCEDURE CHANG	E	Ву	Date Qty	Approval Mfg / Design Mgr	Approval QC Inspector
NCR:			NORK ORDER	NON-CONFORMANO	CE (NCR)	L		
				orrective Action Section B		1		Approval QC Inspecto
DATE	STEP	Description of NC Section A	Initial Design Mgr	Action Description Design Mgr	Sign & Date	Verification Section C	Approval Design Mgr	
	•			·				
	-							
				,				
				·				
Part No	):	PAR #:	Fault Category: _	NCR: Y	es No C	QA:	Date:	
NOTE: Date & initial all entries			d	QA: N/C Clo	sed:		· · · · · · · · · · · · · · · · · · ·	

DART AEROSPACE LTD	Work Order:	28080
Description: Inner Fwd Saddle	Part Number:	D5953
Inspection Dwg: D5953 Rev. A		Page 1 of 1

Inspect dimensions highlighted on inspection sheet drawing D5953 Rev. A and record below:


				Recorded Actual Dimens			ons		
Dim	Min	Max	Go/No Go Gauge	1	2	3	4	Ву	Date
Α	0.438	0.443	<del>-DT868</del> 2	6.440	0,440	0440	0.440		
В	1.745	1.755		1.749	1,745	1.321	1.351_		
С	5.245	5.255		5.248	5.52F	2.521	5.251		
D	6.995	7.005		7.000	7.001	4.002	7.001		
É	5.745	5.755		5.749	5.750	5.750	5.750		
F	4.745	4.755		4.746	4,747	4.751_	4.750		
G	0.313	0.318	< <del>DT8686</del>	0.315	0.31	0.315	0.315		
Н	1.522	1.532		1.527	1.526	1.526	1.525		
1	3.048	3.058		3.054	3, <b>0</b> 5Z	3.056	3.055		
J	4.575	4.585	<u>.</u>	4.578	4.581	4.582	4.582		
K	0.313	0.318	<b>23-8680</b>	0.315	0.315	0.315	0.315		
L	0.240	0.260		0.248	0.250	0.252	0.249		
М	0.490	0.510		0.498	6.500	0499	0499		
N	0.240	0.260		0.25	0.255	6256	0.251		
0	7.990	8.010		8.004	8003	8003	8.004		
Р	0.240	0.260		0.252	0.248	0.249	0.248		
Q	0.307	0.312		0.311	0:310	0.310	0.311		
R	0.760	0.765		0.765	0.765	0.765	0.765		
S	0.490	0.510		0.500	0.500	0.498	0.438		
Т	1.375	1.395		1.379	1.381	1.380	1.380		
U	2.000	2.020	DT8696-A/B	2.000	2.000	2.800	Q.000		
V	0.623	0.043		0.030	0.030	0.030	<u>0.03</u> 0		
W									
Χ									
Υ									
Z									
AA					`				
AB			<del>-</del>						
AC							-		
AD				·					
AE									
AF									
AG									
AH			A41*						
	Acc	ept/Reje	ct						

Measured by:	Audited by	and
Date: 66111 \(\alpha\)	Date:	01./11/08

ſ	Rev	Date	Change	Revised by	Approved
	Α	99.04.19	New Issue	RF	
	В	02.12.13	Reformat; Added Dim. T-U & DT8682, DT8686 & DT8696 A/B	KJ/RF 📑	#



DESIGN	DRAWN BY	DART AEROSPACE LT	
CHECKED	APPROVED	DRAWING NO.	REV. A
2008	BW	D5953 si	HEET 1 OF 1
DATE		TITLE	SCALE
97.05.06		INNER FWD SADDLE	

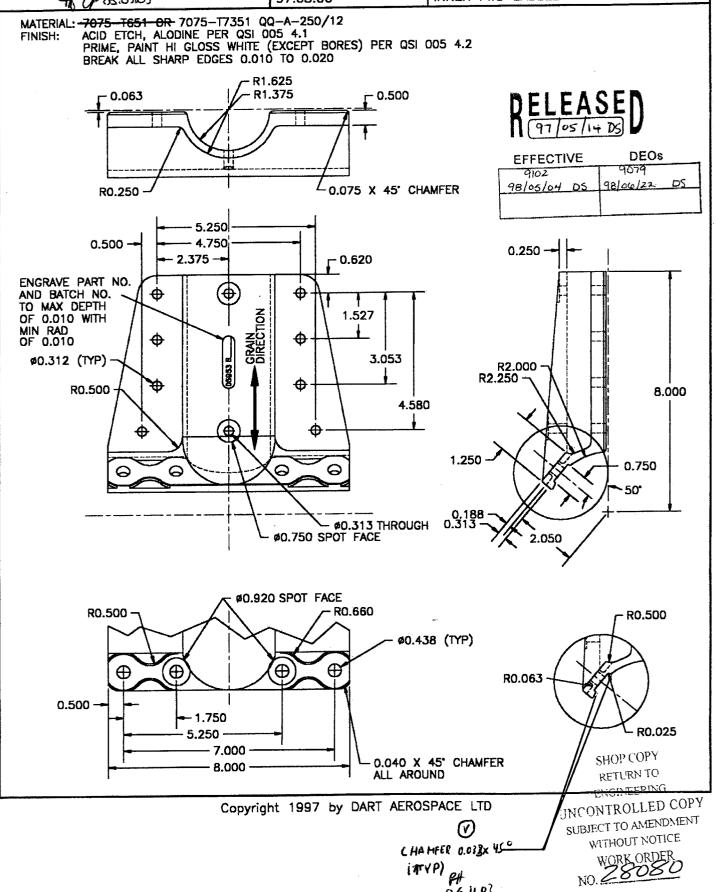

06.11.03

## Peter Hum

From:

David Shepherd [dshepherd@dartaero.com]

Sent:

November 3, 2006 10:22 AM

To:

'Peter Hum'

Subject: RE: D5951/D5953/D5955/D5957

This change is acceptable to me.

David

**From:** Peter Hum [mailto:phum@dartaero.com] Sent: Thursday, November 02, 2006 2:33 PM

To: 'David Shepherd'

Subject: D5951/D5953/D5955/D5957

David,

Last year we made a change to the ridges on the 205 saddles (we made a 0.033" X 45 degree chamfer) which I've attached.

Production is making a run of the extended high gear saddles D5951/D5953/D5955/D5957. Can the changes made to the 205 saddles be applied to the x-tended high gear saddles?

The extended high gear goes onto the same D205-634 skidtubes

Chris Bell is currently updating the D5951/D5953/D5955/D5957 saddles and if this change is acceptable, we will add it in

Peter

No virus found in this incoming message.

Checked by AVG Free Edition.

Version: 7.1.409 / Virus Database: 268.13.23/513 - Release Date: 11/2/2006

No virus found in this outgoing message.

Checked by AVG Free Edition.

Version: 7.1.409 / Virus Database: 268.13.23/513 - Release Date: 11/2/2006

